


# 60 Owens Drive

Wayne, Passaic Co., New Jersey



# 60 Owens Drive

Wayne, Passaic Co., New Jersey

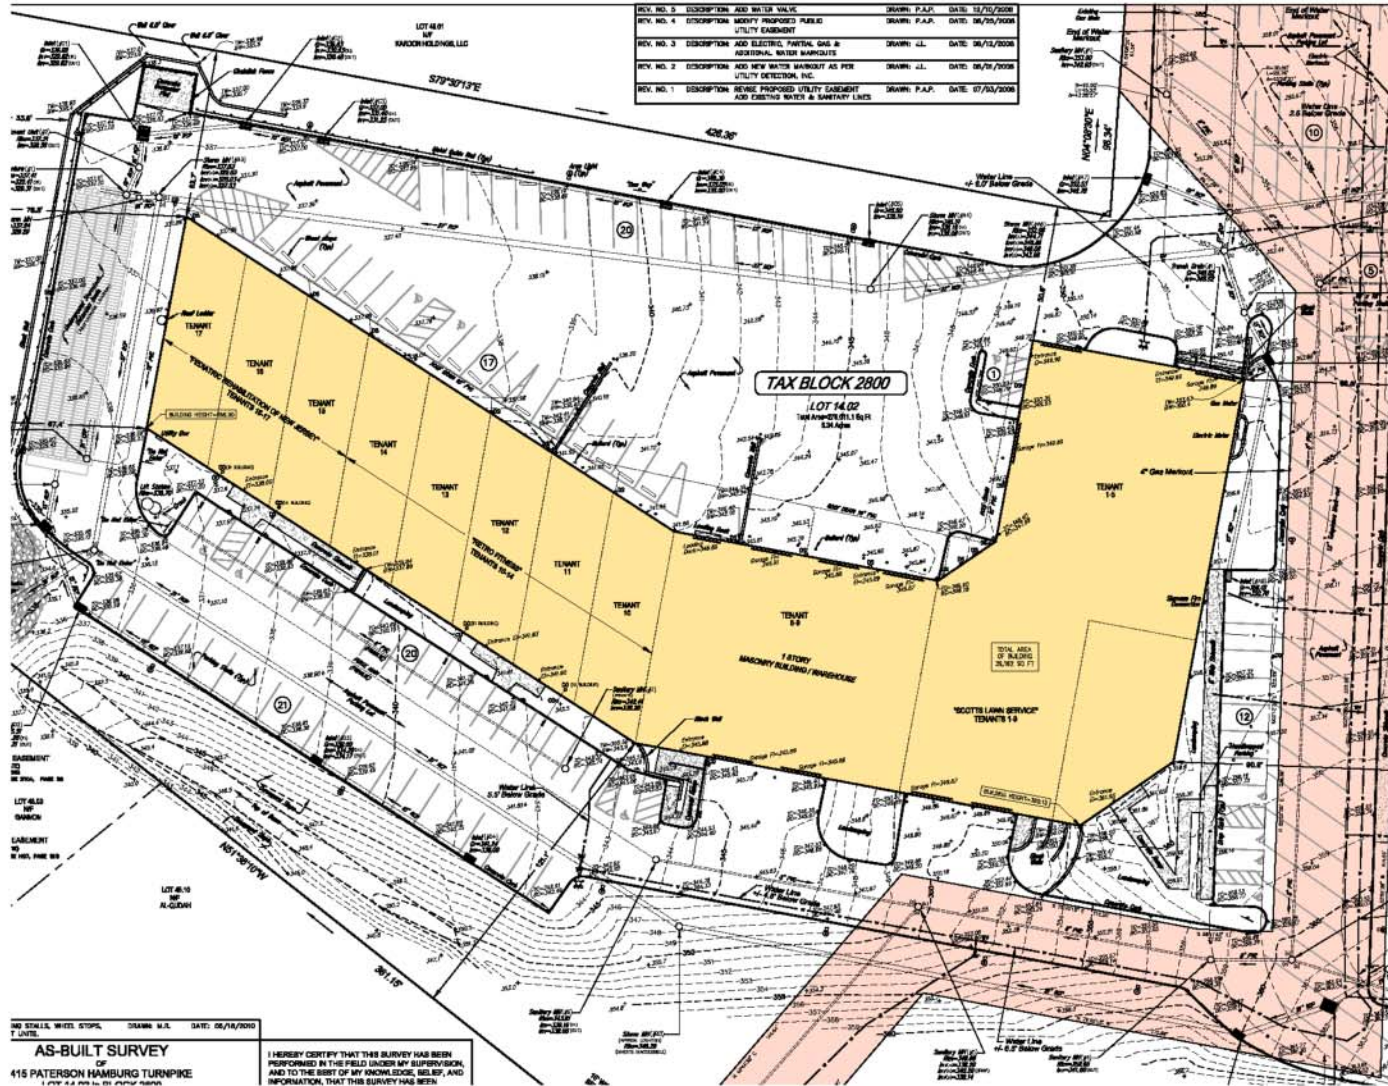

REV. NO. 5	DESCRIPTION: ADD WATER VALVE	DRAWN: P.A.P.	DATE: 11/20/2008
REV. NO. 4	DESCRIPTION: MODIFY PROPOSED PUBLIC UTILITY EASEMENT	DRAWN: P.A.P.	DATE: 06/19/2008
REV. NO. 3	DESCRIPTION: ADD ELECTRIC, NATURAL GAS & ADDITIONAL WATER MAINS/OUTS	DRAWN: J.L.	DATE: 06/12/2008
REV. NO. 2	DESCRIPTION: ADD NEW WATER MAIN/OUT AS PER UTILITY DESIGN, INC.	DRAWN: J.L.	DATE: 06/19/2008
REV. NO. 1	DESCRIPTION: REMOVE PROPOSED UTILITY EASEMENT AND EXISTING WATER & SANITARY LINES	DRAWN: P.A.P.	DATE: 07/20/2008

300 STALLS, WHEEL STOPPS  
 1 LANE  
 AS-BUILT SURVEY  
 OF  
 415 PATERSON HAMBURG TURNPIKE  
 1/27/11 BY J.L. TURNPIKE

I HEREBY CERTIFY THAT THIS SURVEY HAS BEEN PERFORMED BY THE FIELD UNDER MY SUPERVISION AND TO THE BEST OF MY KNOWLEDGE, BELIEF, AND INFORMATION, THAT THIS SURVEY HAS BEEN